

D

C

B


A

D

C

B

A

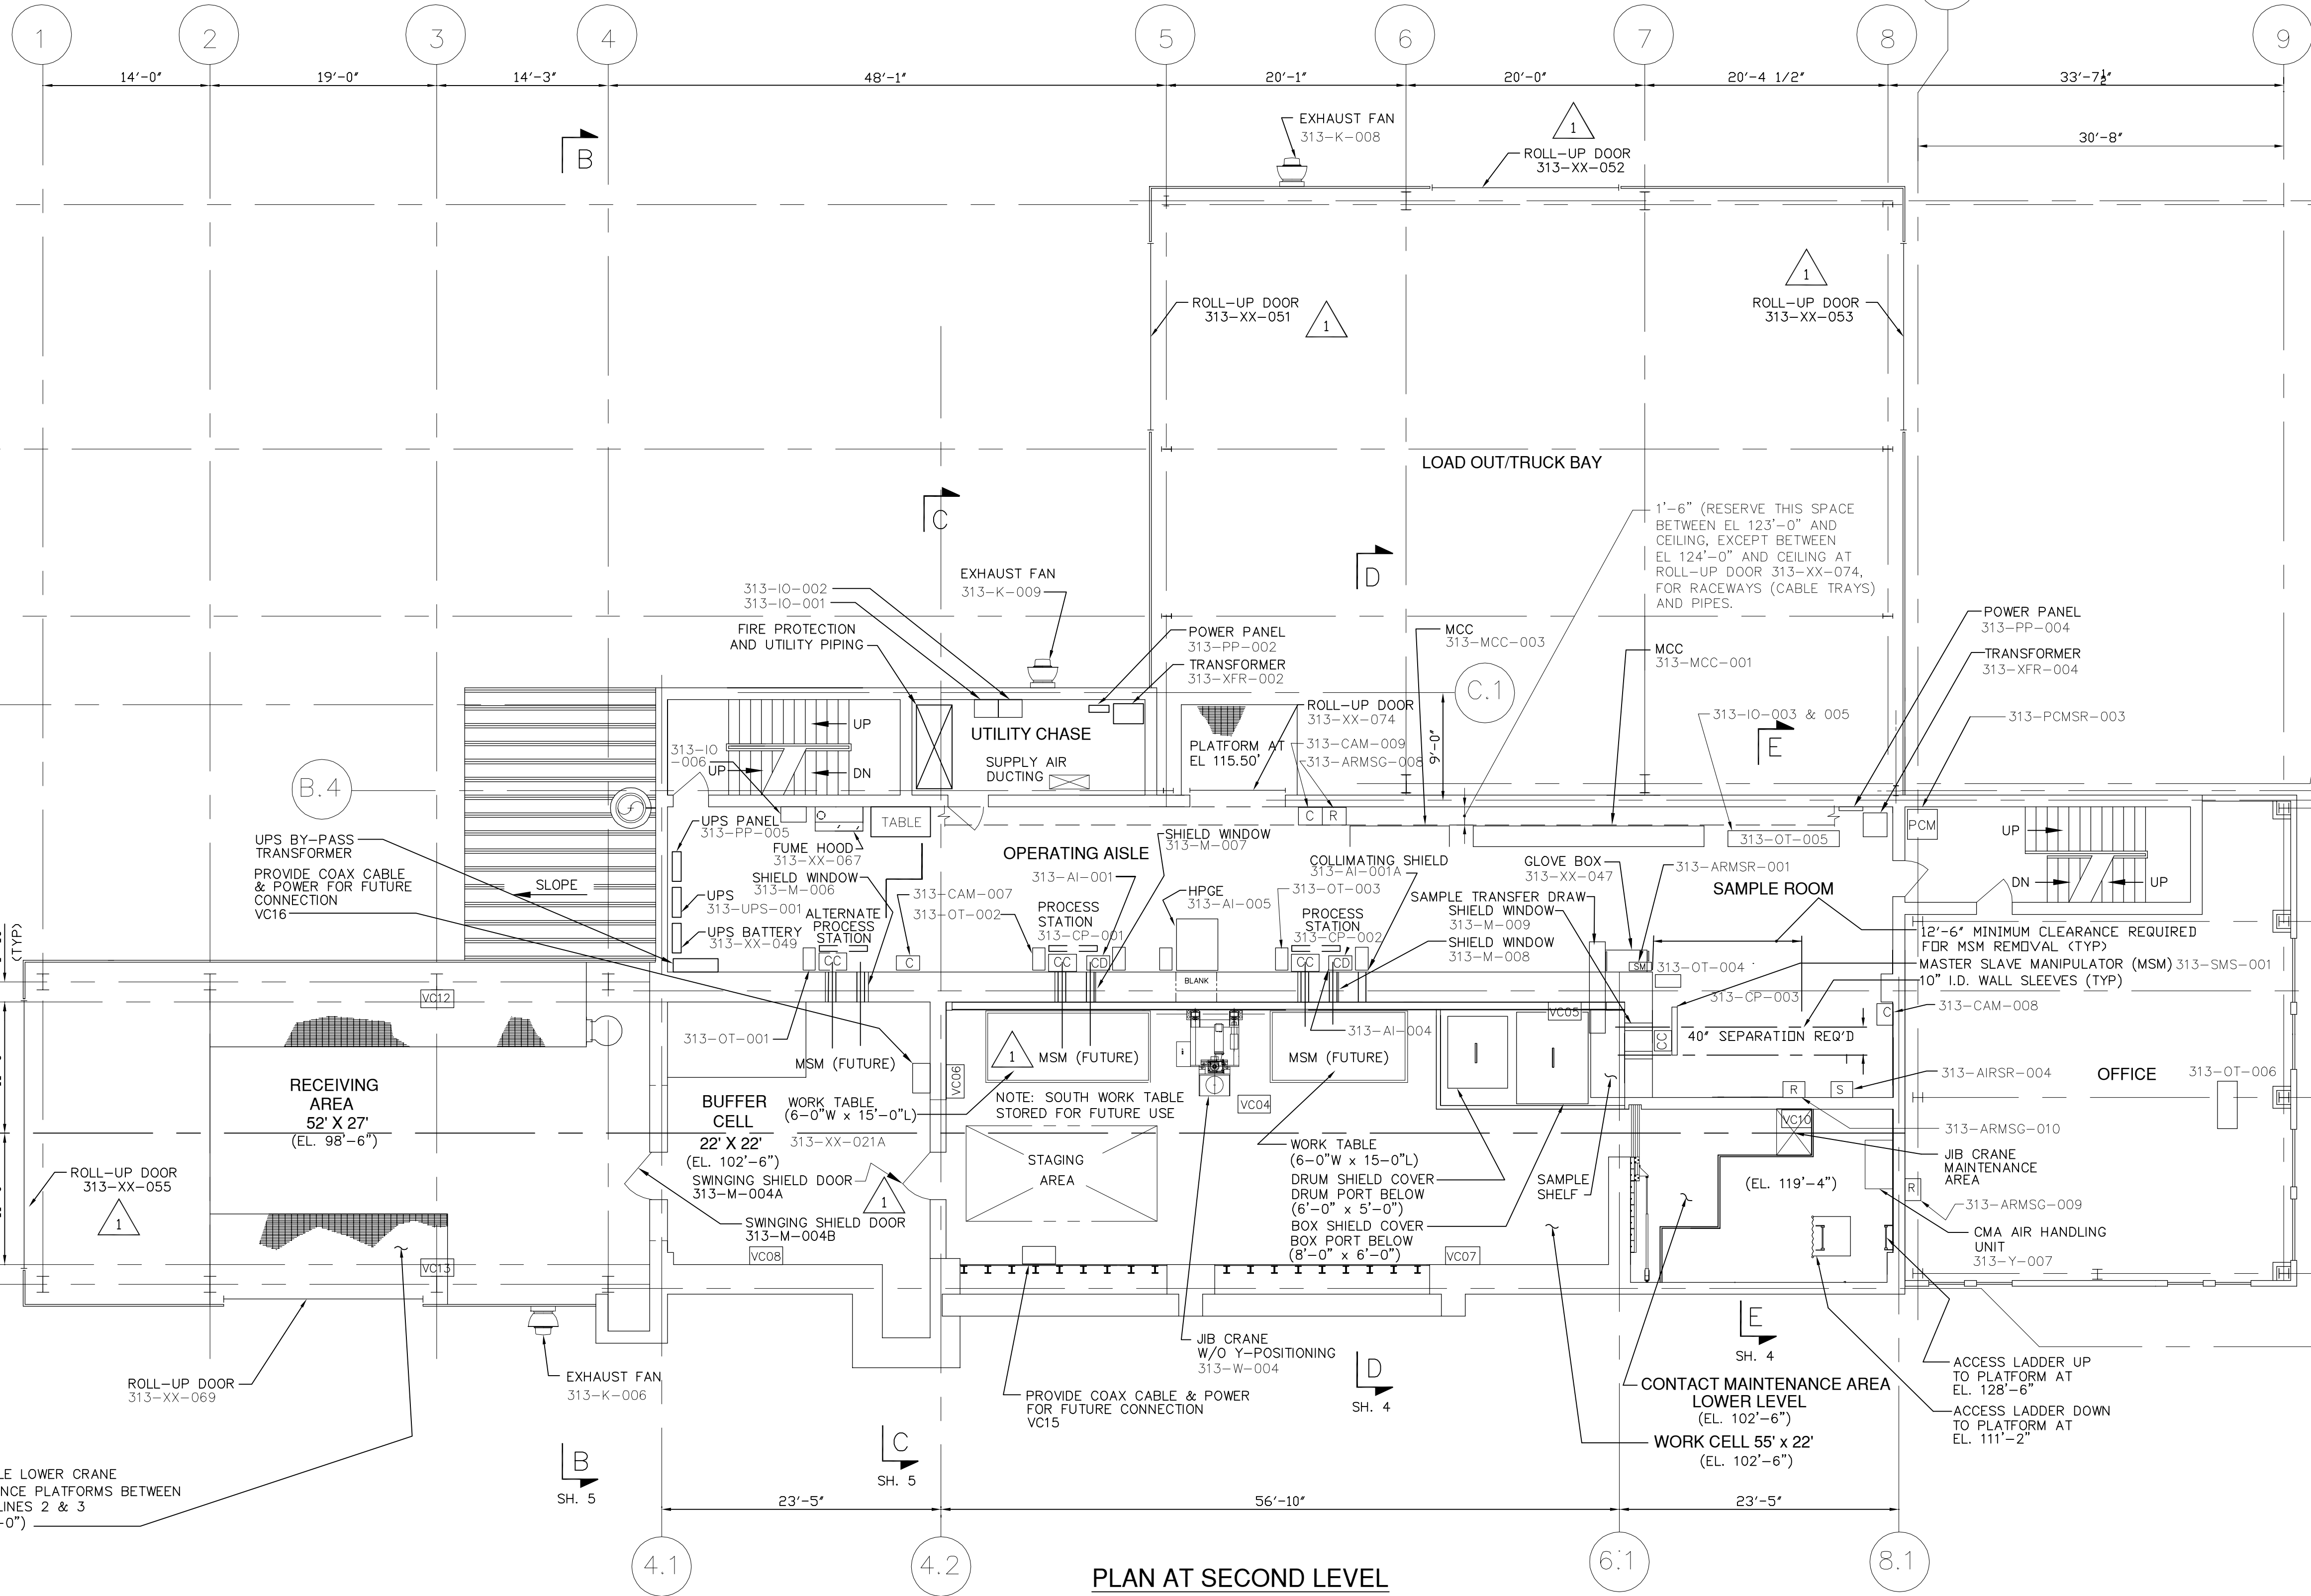

PLAN AT SECOND LEVEL
FINISHED FLOOR ELEVATION @ 115'-6" (UNLESS NOTED)
DETAIL AT FIRST LEVEL
NOT SHOWN FOR CLARITY

AS BUILT

| REV | DESCRIPTION | APVD |
|-----|--|---|
| 1 | INCORPORATE THE FOLLOWING DCS: 058, 059, 060, 061, 062, 063, 066, 069, 069 R1, 070, 071, 072, 073 & 076 | MC/AR 5/24/01 AWU 058, 059, 060, 061, 062, 063, 066, 069, 069 R1, 070, 071, 072, 073 & 076 |
| 2 | FOR ACTION ITEM 069, GENERAL REVISION AS CIRCLED | WN 06/22/01 EON 06/22/01 |
| 3 | GENERAL REVISION AS CIRCLED | MC 07/16/03 EON 07/16/03 |
| 4 | REVISED AS CIRCLED | WN 02/23/04 EON 02/23/04 |
| 5 | EDITORIAL CHANGES PER WNS REQUEST | |
| 6 | ER 25966 M/23/2004 | CCG |
| 7 | EON 25963 HAB 04/29/2004 | HAB |

VERIFY ALL DOCUMENTS FOR CURRENT REVISION AND PENDING CHANGES PRIOR TO EACH USE
INIT _____ DATE _____

| | | |
|---|--|-------------|
| UNLESS OTHERWISE SPECIFIED ALL DIMENSIONS IN INCHES | DRAFTER VENDOR | DATE |
| FILE NAME 911_D_030_002_000 | CHECKER VENDOR | DATE |
| PLOT SCALE 1=96.00 | ENGINEER VENDOR | DATE |
| D SPEC # 0000 | DATABASE LINKED DRAWING | DWG SIZE |
| NEXT ASSEMBLY | SEE ENGINEERING RELEASE FORM (ERO) FOR DRAWING APPROVAL SIGNATURES | SCALE 1:96 |
| | | WEIGHT |
| | | A/E DWG # |
| | | SHEET 2 OF |
| | | DWG IDENT # |

VENDOR: BUTLER CONSTRUCTION CO. OF WNY, INC.
RAYTHEON NUCLEAR, INC.
rnr
WVNSCO
West Valley Nuclear Services Company

RHW
GENERAL ARRANGEMENT
PLAN AT SECOND LEVEL

911-D-030 1
SHEET 2 OF

CAD DRAWING-DO NOT
REVISE THIS ORIGINAL